



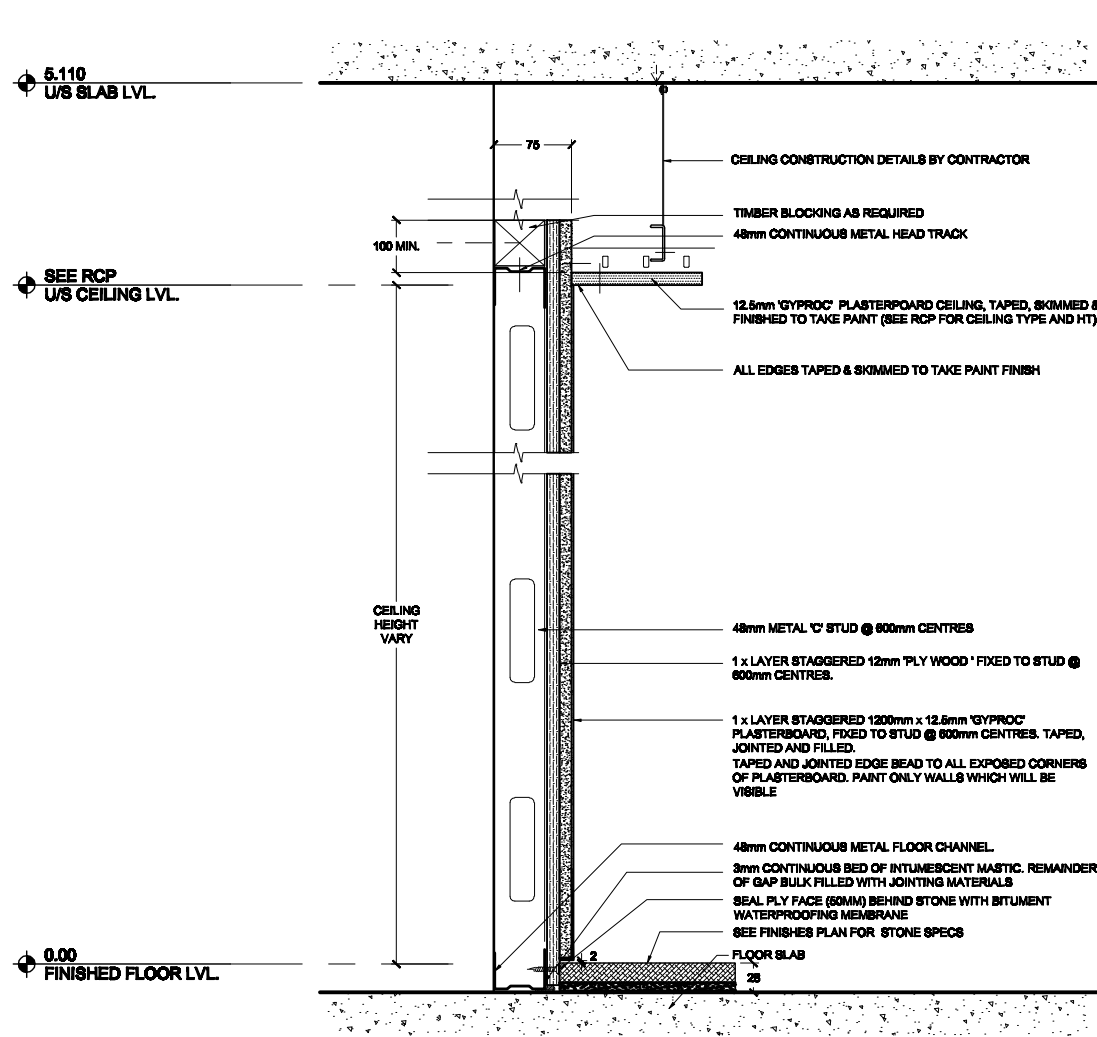

C SECTION DETAIL
PARTITION TYPE W 1:5

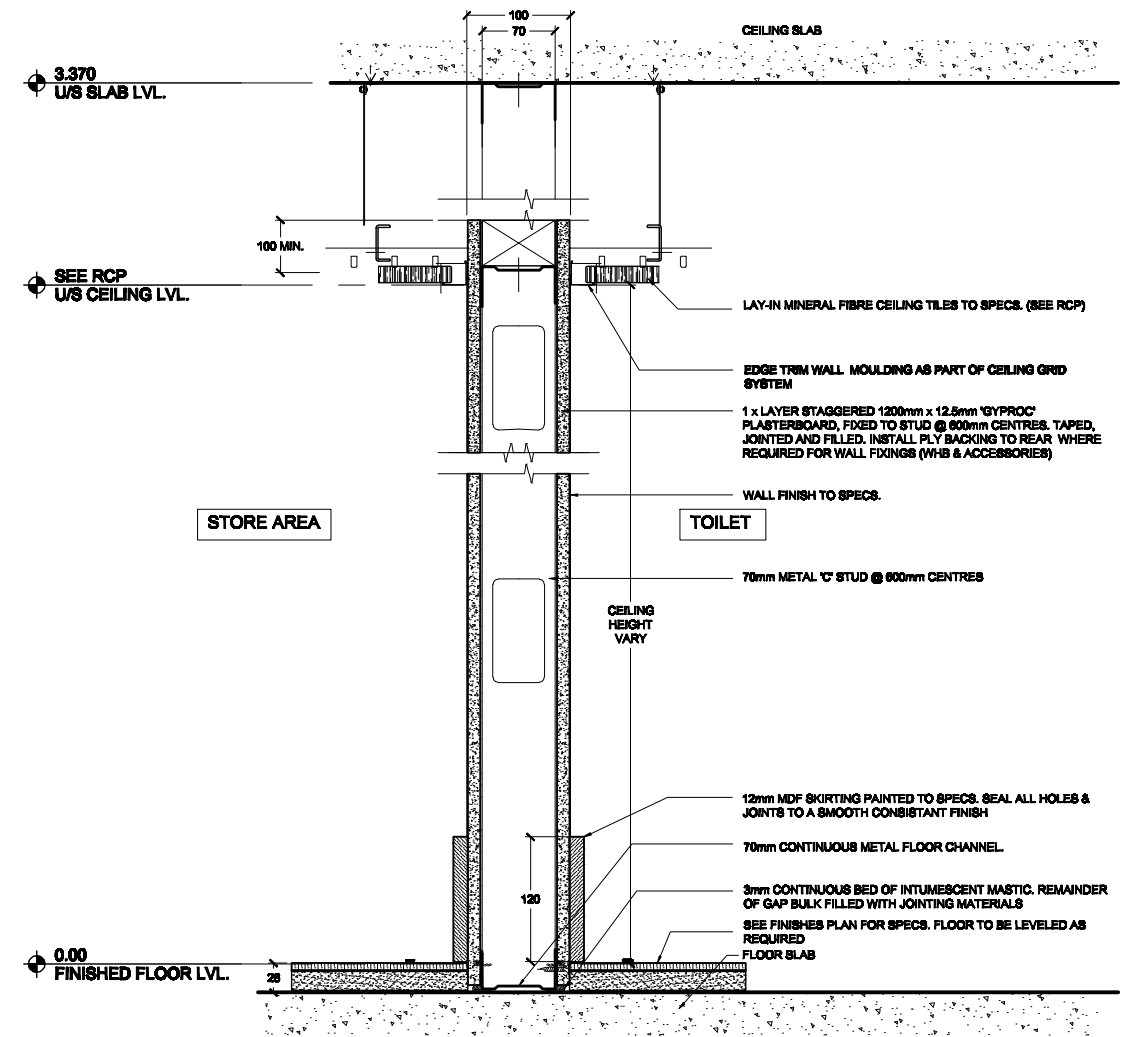

D SECTION DETAIL
PARTITION TYPE W 1:5

Tom Giannini Architects

WEST ENTRANCE - SECOND FLOOR
1-3 DUFFERIN STREET, LONDON EC1Y 8NA

020 7638 1226
020 7638 1227
www.tgarch.co.uk
info@tgarch.co.uk

NOTES

XXXXXXXXXX

AS BUILT
MAR '07


ALL DIMENSIONS TO BE VERIFIED BY THE CONTRACTOR ON SITE.
ALL DIMENSIONS IN MILLIMETERS
ANY DISCREPANCIES TO BE REPORTED TO THE ARCHITECT IMMEDIATELY.
DO NOT SCALE FROM DRAWING.

Tom Giannini Architects

ORIENTATION:



SCALE:

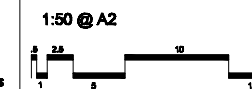

DRAWN BY:

VM

CHECKED BY:

PVG

PROJECT No:

00633.00

CLIENT:

SERGIO ROSSI

PROJECT ADDRESS:

207 SLOANE STREET
LONDON
SW1X 9QX

00633.00

DRAWING TITLE

GROUND FLOOR
PARTITION DETAILS

DRAWING No:

DE-3.1

AS BUILT -